



WESTINGHOUSE, CHURCH, KERR & Co.
ENGINEERS
8 & 10 BRIDGE ST, NEW YORK.

Drawn by J.G. & M.
Checked by H.S.T.Q. 1.

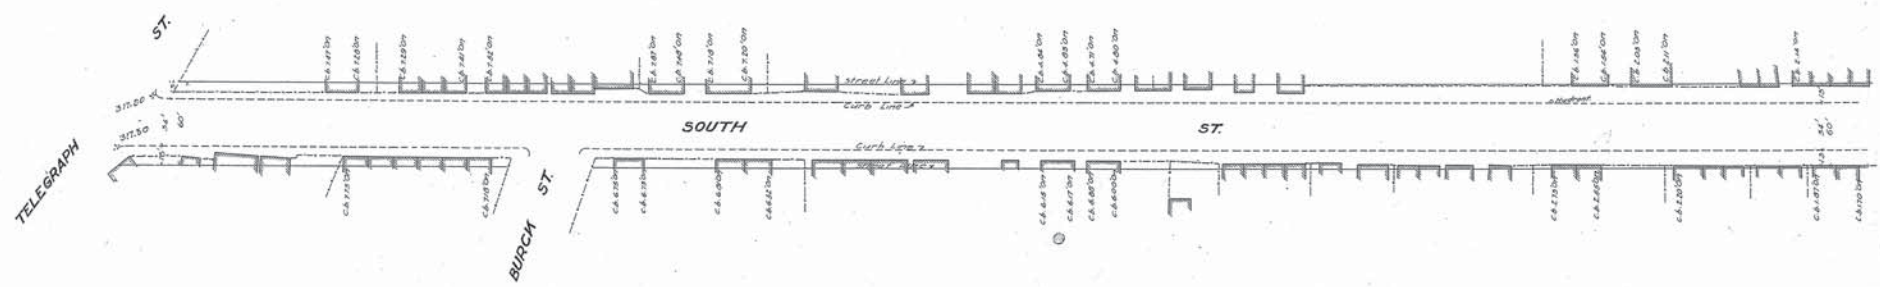

Note: The line shown in red and marked street line
represents a line beyond which no buildings
shall be built.
The grade line shown on profile is an
average grade between curbs.

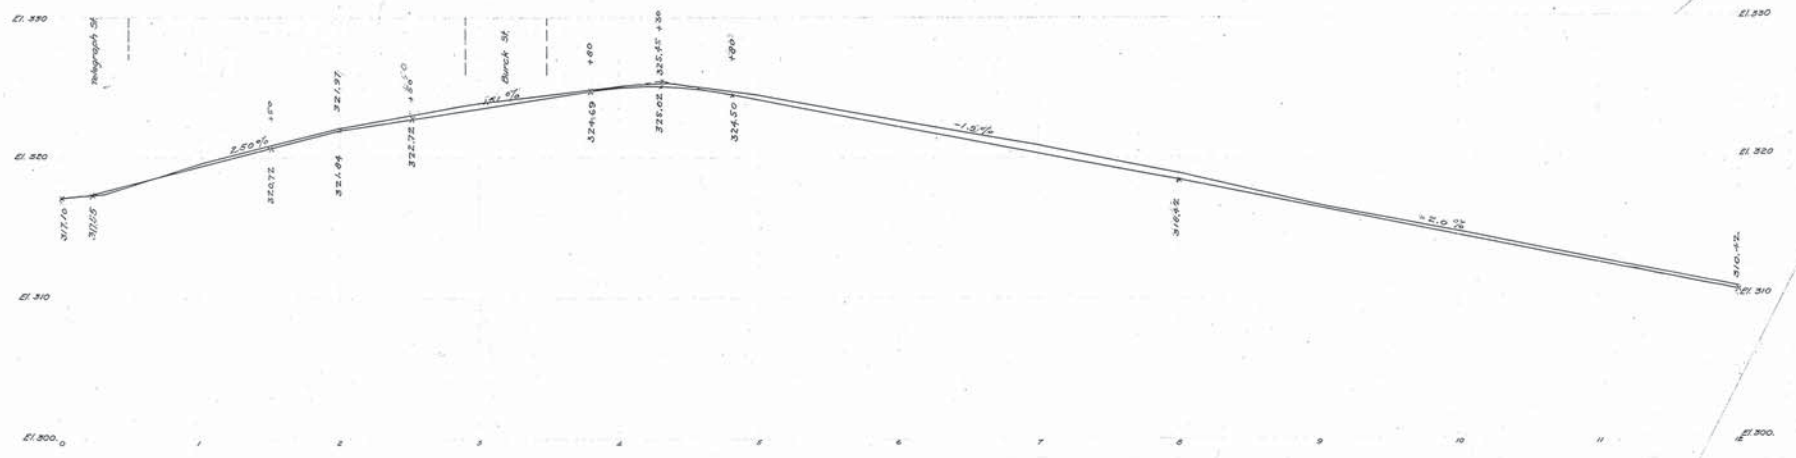

Adopted by The Mayor and Aldermen of Frederick
by ordinance passed and approved Dec. 3, 1909.

Attest:
W. H. McCaffrey
City Registrar.

The Mayor and Aldermen of Frederick.
By
Alfred Smith Mayor.


FREDERICK CITY.
PLAN & PROFILE OF SOUTH STREET.
SHOWING ESTABLISHED GRADE & STREET LINE.
Scale 1" = 20' Vert.
Frederick Md. Sept 24, 1907.
Sheet 1 of 6 Sheets.

N.Y. No 1984.
P-6-F-1


WESTINGHOUSE CHURCH, KERR & Co.
ENGINEERS
6 & 10 BRIDGE ST., NEW YORK.

Drawn by J.G. & M.C.
Checked by A.L. & J.G.

2.

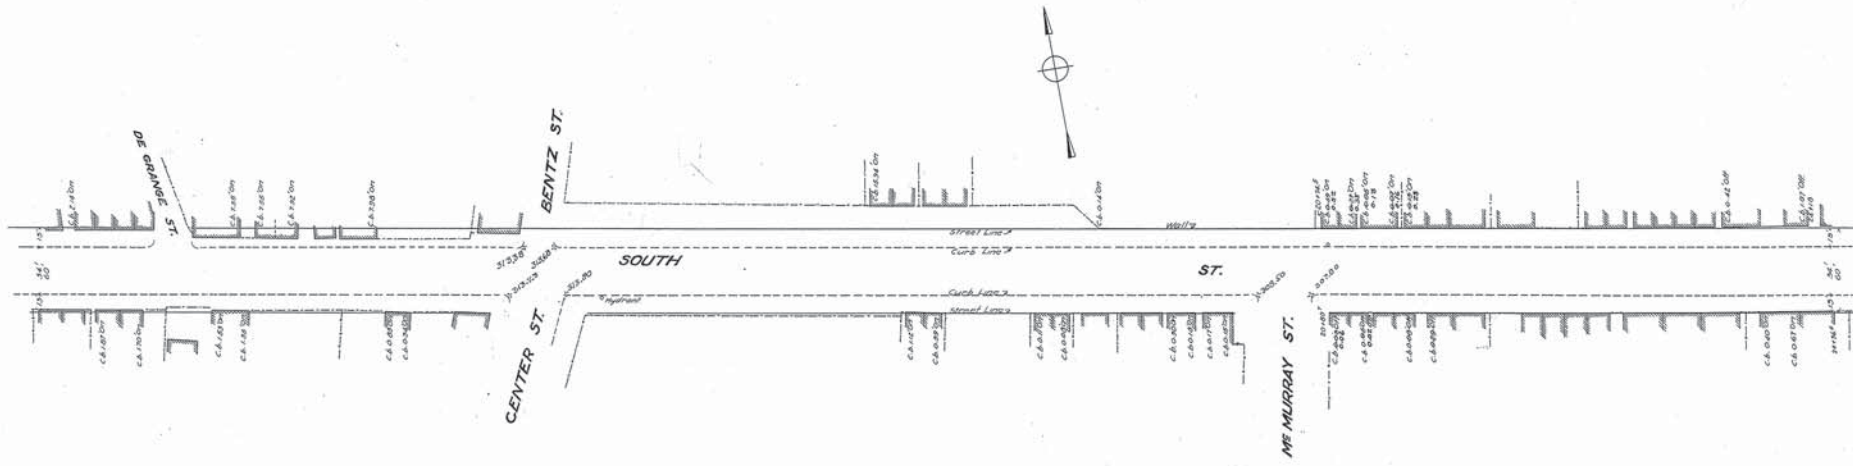

Note: The line shown in red and marked street line represents a line beyond which no buildings shall be built.
The grade line shown on profile is an average grade between curbs.
Green figures approved June 6, 1910

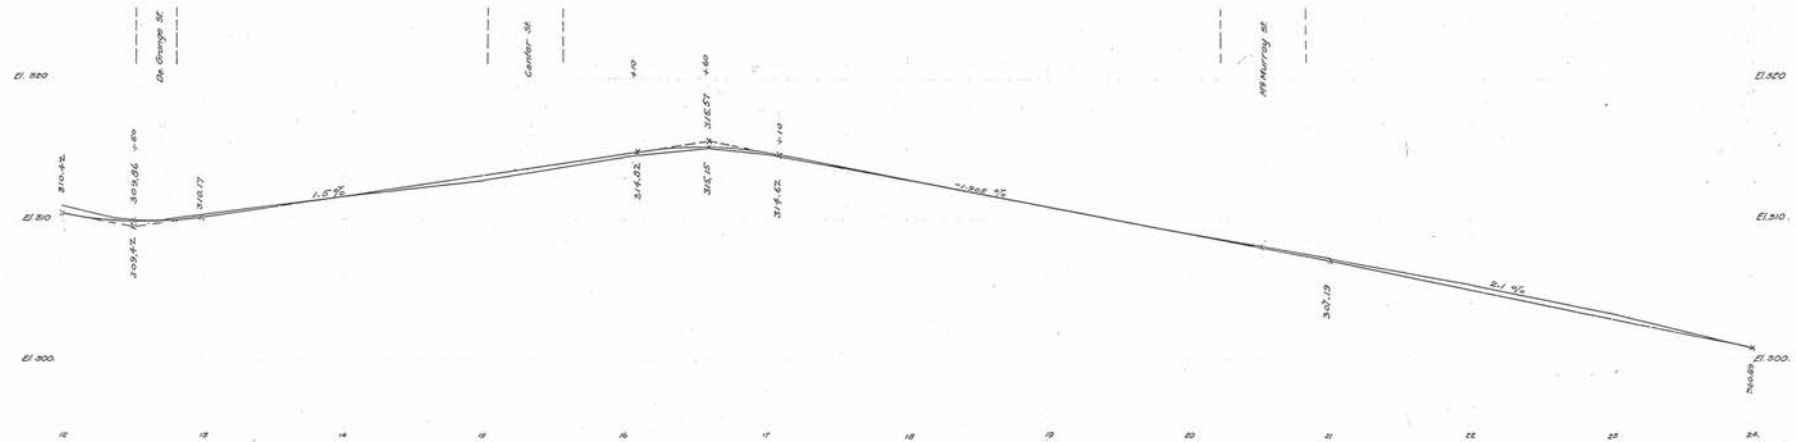

Repealed and reenacted by ordinance
passed and approved June 6, 1910

Adopted by The Mayor and Aldermen of Frederick
by ordinance passed and approved Dec. 3, 1909

Attest
M. U. McCaffrey
City Registrar

The Mayor and Aldermen of Frederick
by *Geo. Edwin Smith*
Mayor

Attest:
M. U. McCaffrey
City Registrar.

The Mayor and Aldermen of Frederick
By *Geo. Edwin Smith* Mayor.

FREDERICK CITY.
PLAN & PROFILE OF SOUTH STREET.


SHOWING ESTABLISHED GRADE & STREET LINE.
Scale: [1"=40' for Frederick Md. Sept 24, 1907.

Sheet 2 of 6 Sheets.


N. Y. No. 19842.
P. 6-F-1

19642
WESTINGHOUSE CHURCH, KERR & CO.
SOUTH STREET

WESTINGHOUSE, CHURCH, KERR & Co.
ENGINEERS
8 & 10 BRIDGE ST, NEW YORK.

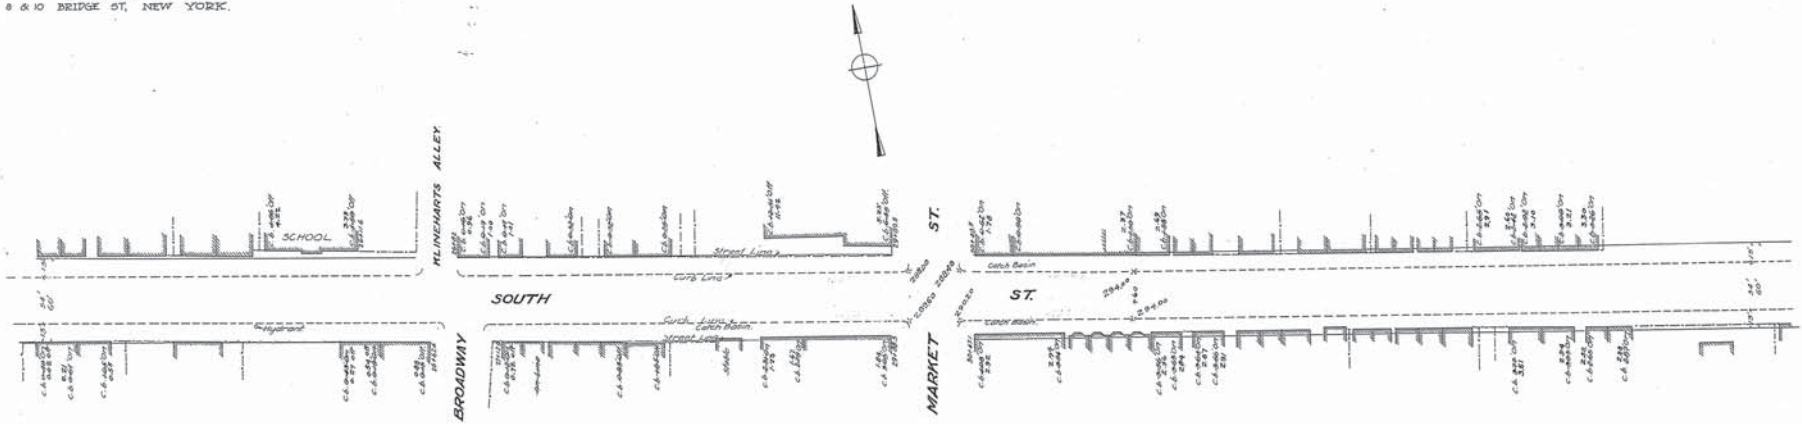

Note: The line shown in red and marked street line represents a line beyond which no buildings shall be built.
The grade line shown on profile is an average grade between curbs.
Elev. figures approx'd June 6, 1913.

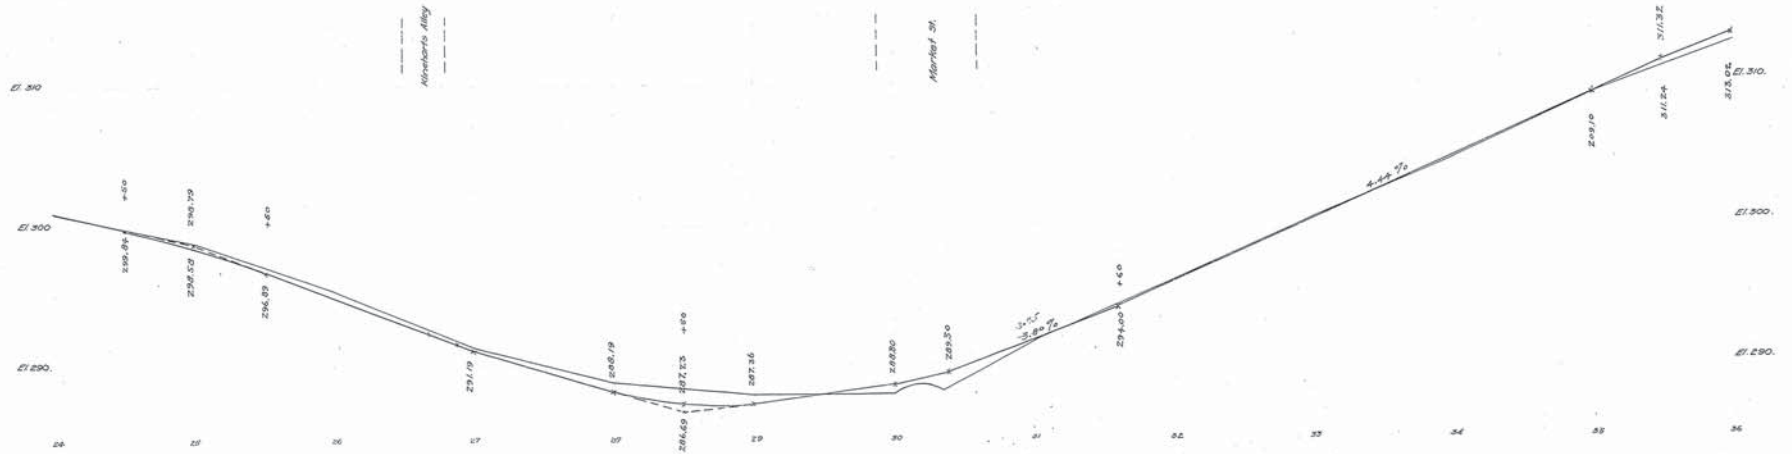

Repealed and reenacted by ordinance passed and approved June 6, 1910

Adopted by The Mayor and Aldermen of Frederick by ordinance passed and approved Dec. 3, 1909.

Attest

The Mayor and Aldermen of Frederick

By *Edo Smith*
Mayor

Attest:

M. A. McCaffrey
City Registrar

The Mayor and Aldermen of Frederick.

By *Edo Smith*
Mayor

FREDERICK CITY.
PLAN & PROFILE OF SOUTH STREET
SHOWING ESTABLISHED GRADE & STREET LINE


Scales: 1"=40' Hor.
1"=40' Vert.

Frederick Md.
Sept 24, 1907.
Sheet 3 of 6 Sheets.


N. Y. No. 19843.

Drawn by J.O. & G.L.
Checked by B.L.S.G.

WESTINGHOUSE, CHURCH, KERR & Co.
ENGINEERS
8 & 10 BRIDGE ST NEW YORK.

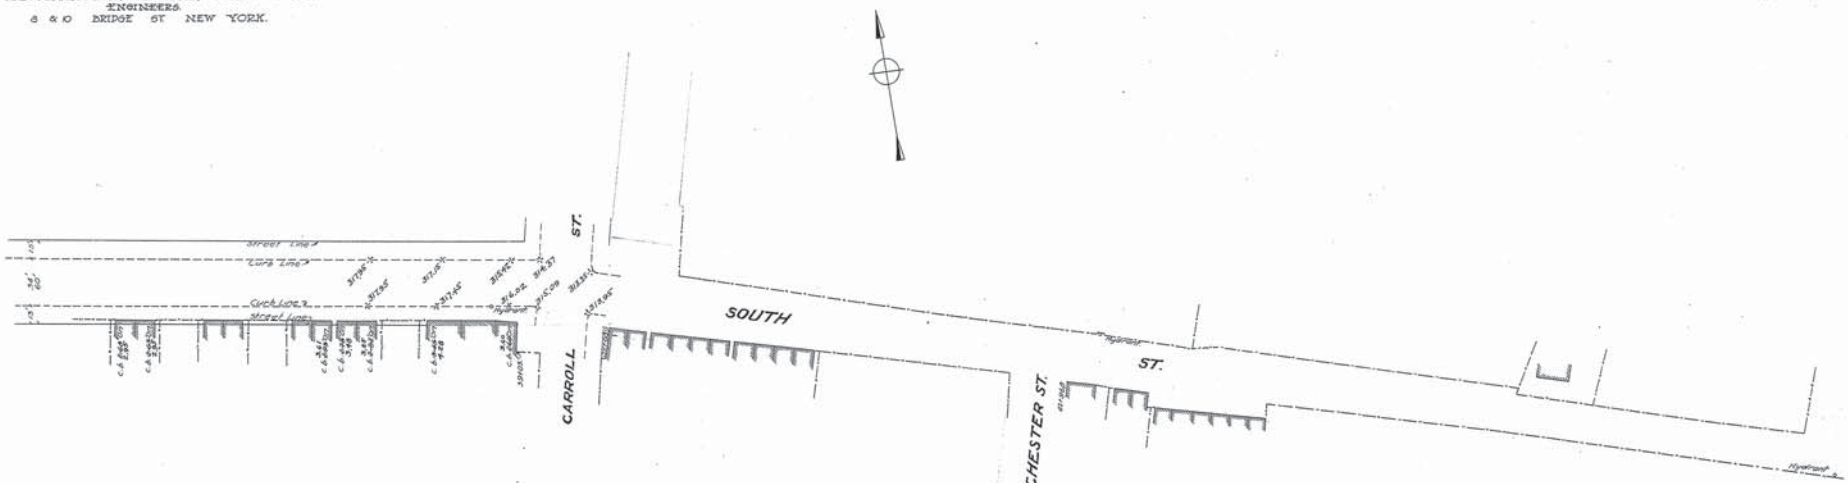

Note: The line shown in red and marked street line represents a line beyond which no buildings shall be built.
The grade line shown on profile is an average grade between curbs
Given figures approx'd Jan 6, 1910

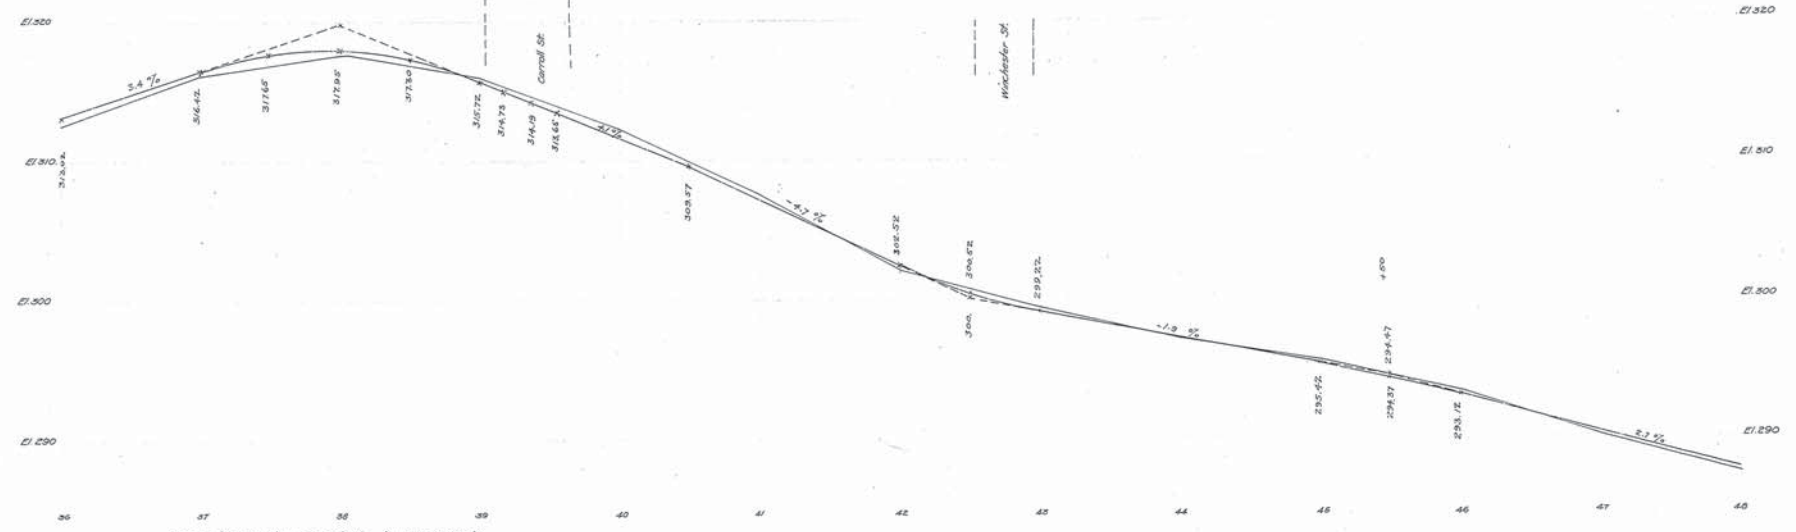

Repealed and re-enacted by ordinance
passed and approved June 6, 1910

Adapted by The Mayor and Aldermen of Frederick
by ordinance passed and approved Dec. 3, 1909.

Attest:
M.A. McCaffrey
City Registrar

The Mayor and Aldermen of Frederick
Attest:
Wm. McCaffrey
City Registrar

The Mayor and Aldermen of Frederick
Attest:
Wm. McCaffrey
Mayor

FREDERICK CITY.
PLAN & PROFILE OF SOUTH STREET
SHOWING ESTABLISHED GRADE & STREET LINE.
Scales 1" = 40' Horiz.
1" = 10' Vert.
Frederick Md.
Sept 24 1907.
Sheet 4 of 6 Sheets.


N. Y. No 19844.
P. 6-77

19844
WESTINGHOUSE CHURCH, KERR & CO.
SOUTH STREET


WESTINGHOUSE CHURCH, KERR & Co.
ENGINEERS
8 & 10 BRIDGE ST. NEW YORK.

Drawn by J.G. & B.C.
Checked by H.L. & J.Q.

5

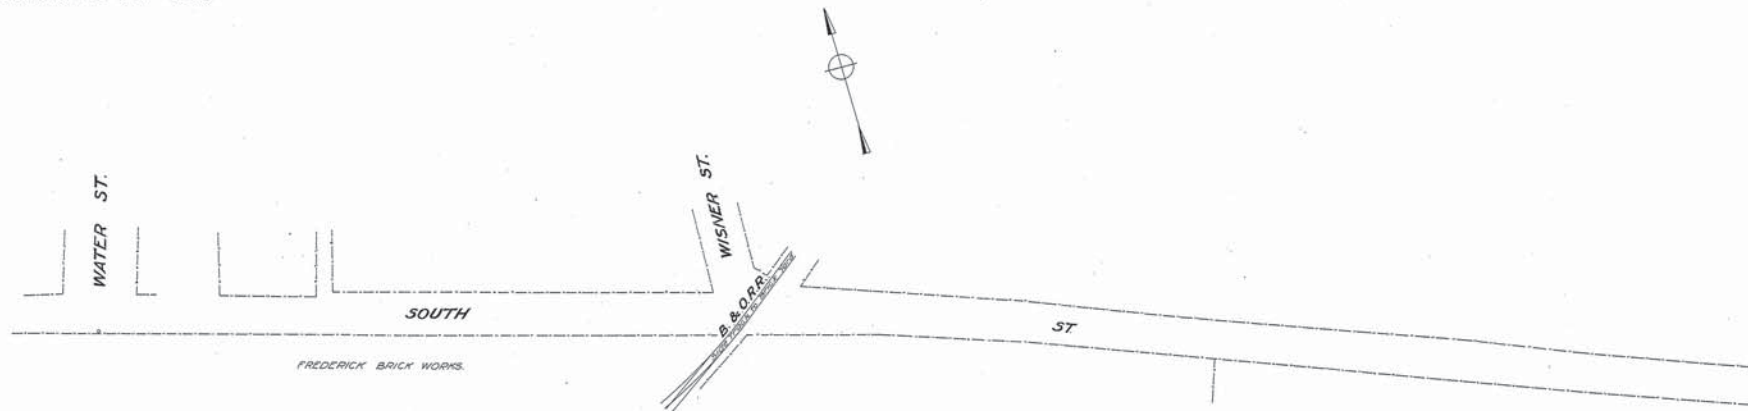

Note: The line shown in red and marked street line represents a line beyond which no buildings shall be built.
The grade line shown on profile is an average grade between curbs.

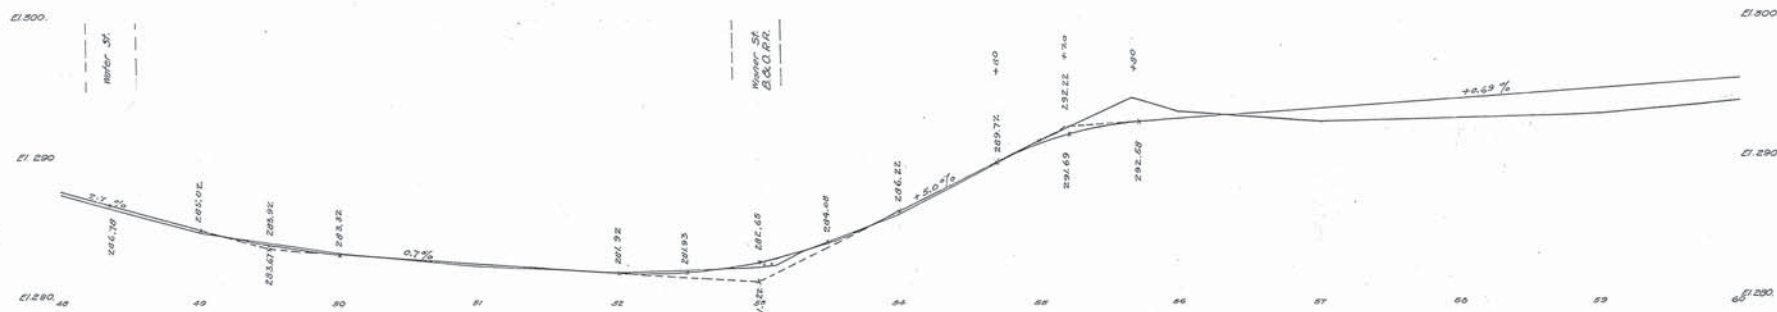

Adopted by The Mayor and Aldermen of Frederick
by ordinance passed and approved Dec. 3, 1909.

Attest:
M. A. McCaffrey
City Registrar.


The Mayor and Aldermen of Frederick,
Edw. Edwards Mayor

FREDERICK CITY.
PLAN & PROFILE SOUTH STREET.
SHOWING ESTABLISHED GRADE & STREET LINE.
Scale: 1" = 40' HORIZ.
1" = 10' VERT.
Frederick Md. Sept. 25, 1907.
Sheet 5 of 6 Sheets.


N.Y. No. 19845

WESTINGHOUSE, CHURCH, KERR & Co.
ENGINEERS
6 & D BRIDGE ST. NEW YORK

Drawn by M.C.H. Checked by T.C.R. 6

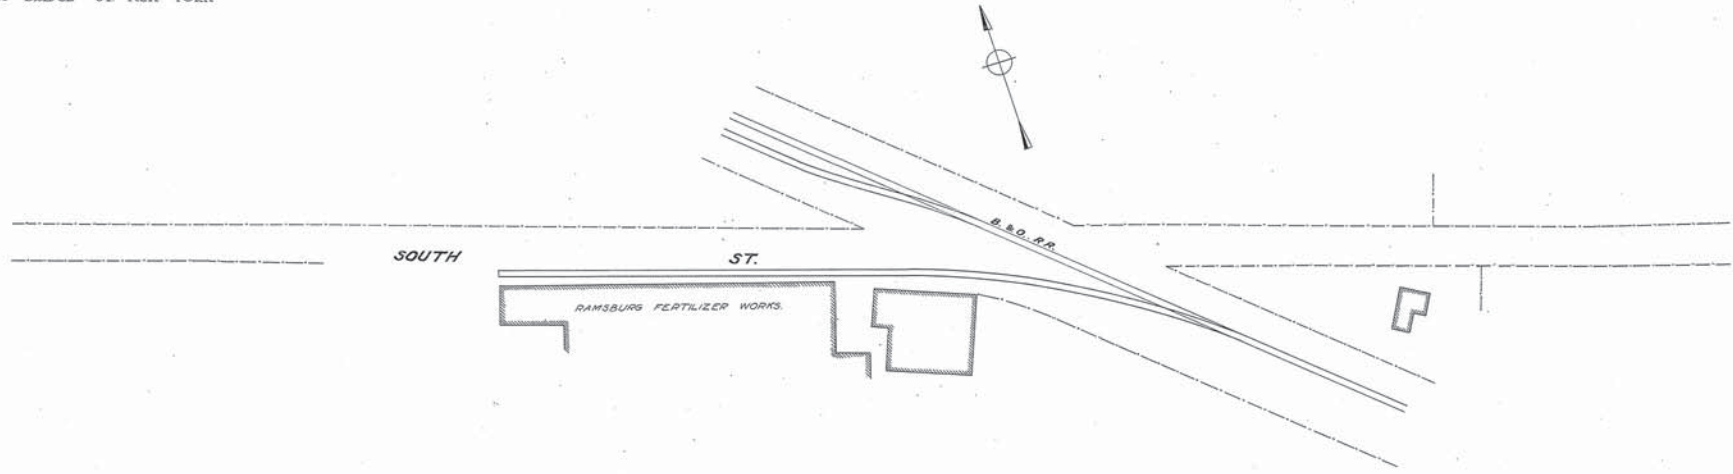

Note: The line shown in red and marked street line represents a line beyond which no buildings shall be built.
The grade line shown on profile is an average grade between curbs.

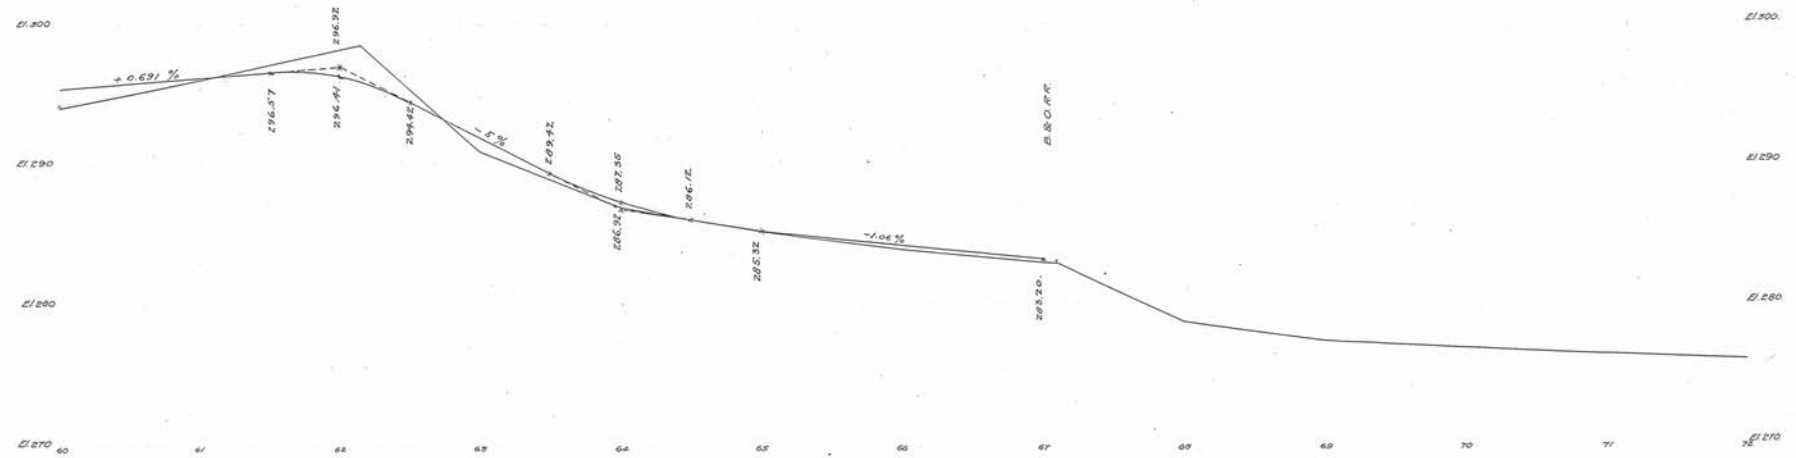

Adopted by The Mayor and Aldermen of Frederick
by ordinance passed and approved Dec. 3, 1909

Attest:
M. C. McCaffrey
City Registrar

The Mayor and Aldermen of Frederick
By *Edwin Smith* Mayor

FREDERICK CITY.
PLAN & PROFILE OF SOUTH STREET.

SHOWING ESTABLISHED GRADE & STREET LINE.
Scale: 1" = 5' Vert. Frederick Md. Sept. 25 1907.
Sheet 6 of 6 Sheets

N.Y. No 19846
p. 6-7-1

19846
WESTINGHOUSE CHURCH, KERR & CO.

SOUTH STREET